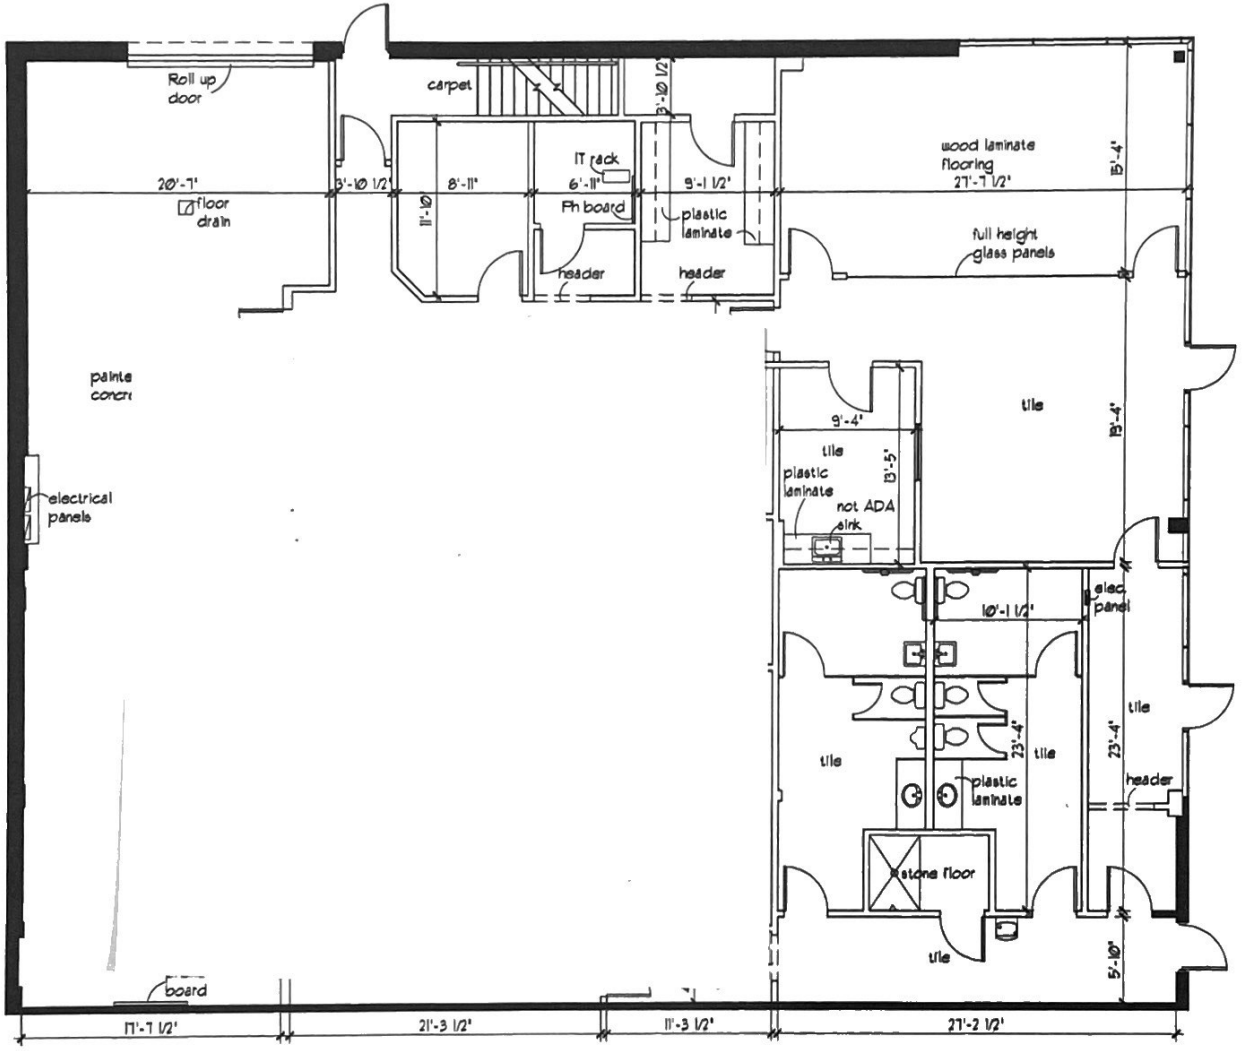

EXISTING WALL

TRIESCHMANN DUMALA
architectural group
6451 EAST ROGERS CIRCLE | SUITE 9 | BOCA RATON | FL 33487
P: 561.981.8000 F: 561.981.8916
AA26002244 AA26002252 WWW.TDARCHGROUP.COM

430 S. CONGRESS - SUITE 1D - FIRST FLOOR

AS-BUILT

NOTE. SPACE NEEDS TO BE REVERIFIED DUE TO SITE CONDITIONS
NOTE. FURNITURE FOR ILLUSTRATION PURPOSES ONLY
NOTE. ROOM SIZES ARE APPROXIMATE

SCALE 1/8" = 1'
DRAWN D.M
08/15/14