CORTEZ ROAD WEST

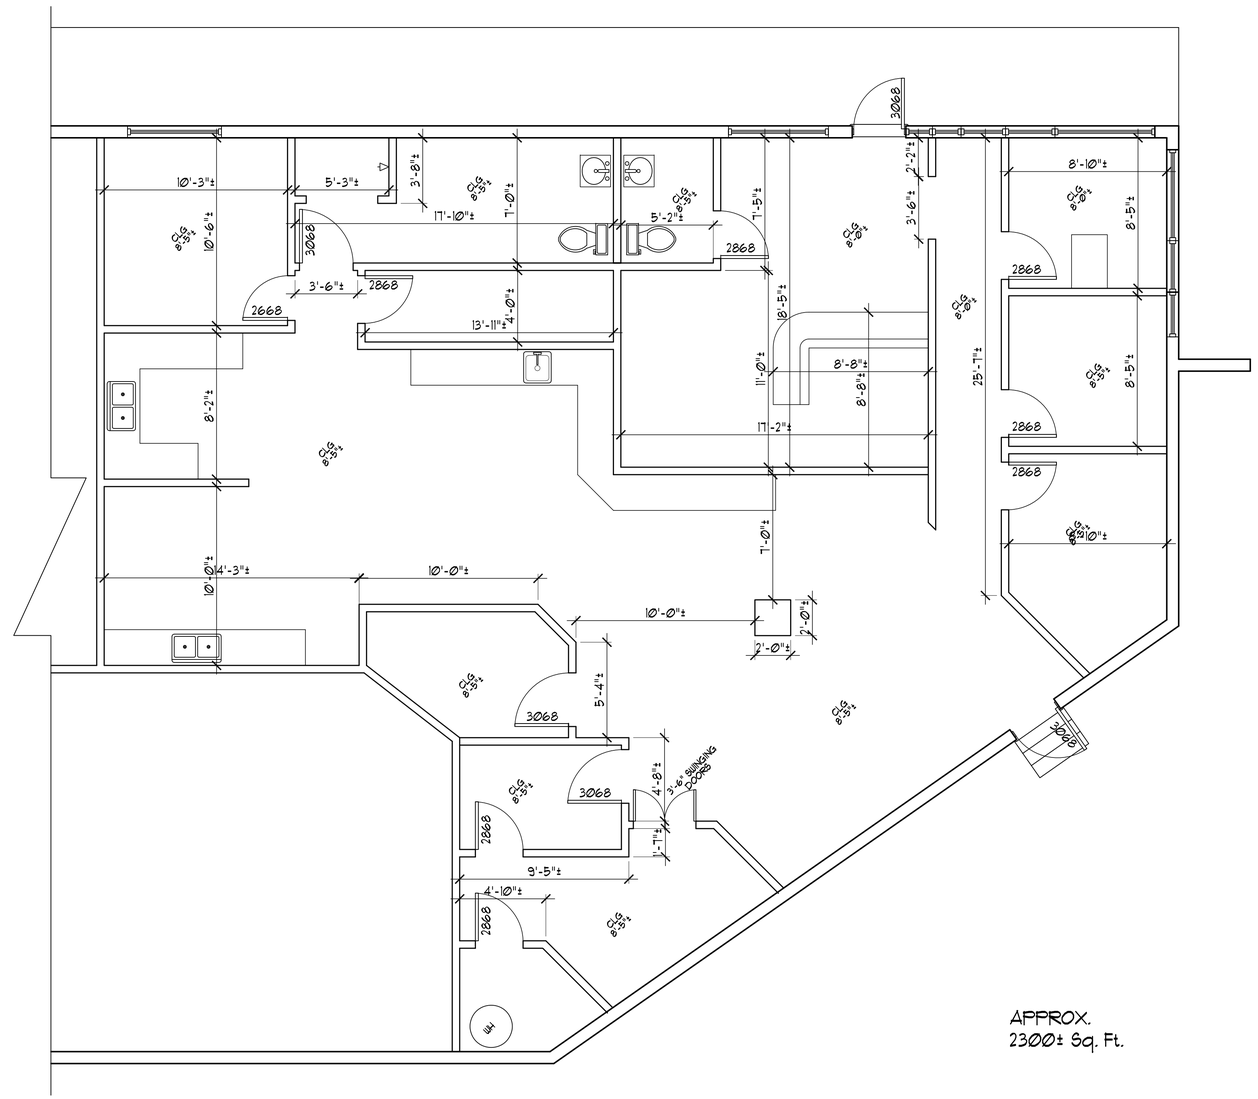

APPROX.
2300± Sq. Ft.

NOTE: ALL DIMENSIONS ARE APPROXIMATE BASED ON THE SKETCH PROVIDED AND THE AS-BUILT CONDITIONS MEASURED IN PLACE. EXACT MEASUREMENTS MUST BE FIELD VERIFIED.

CLIENT:

AS-BUILT DATE: 09/17/24

FINAL DRAFT:

SCALE: 1/4"-1'

REVISIONS:

REVISIONS:

DRAFTED BY: J.M.W.

DESIGNED BY:

TO THE BEST OF THE DRAFTSMAN'S KNOWLEDGE, THE DESIGN REPRESENTED HEREIN HAS NOT INFRINGED UPON ANY EXISTING COPYRIGHTS, CONFIDENTIAL OR PATENTED DESIGNS PREVIOUSLY ASSIGNED TO ANY OTHER PARTY.

ALL RIGHTS RESERVED. REPRODUCTION OF ANY PORTION OF THIS PLANS IS PROHIBITED EXCEPT FOR ONE (1) SET OF PLANS TO BE USED FOR CONSTRUCTION ON ONE (1) BUILDING. THE PLANS FURNISHED ARE THE PROPERTY OF THE DESIGNER. THE PLANS ARE TO BE RETURNED UPON REQUEST OF THE DESIGNER.

TITLE:

3915 Cortez Road West
Bradenton, FL 34210

FINE IMPRESSIONS STUDIOS
DRAFTING & DESIGN
Jeffrey M. Wilson
920 59th Street West
Bradenton, FL 34209
941.526.6508

SHEET #

1

1 OF 1