SERPICO REALTY

Tallahassee, Florida 05.01.2025

CONN + ARCHITECTS

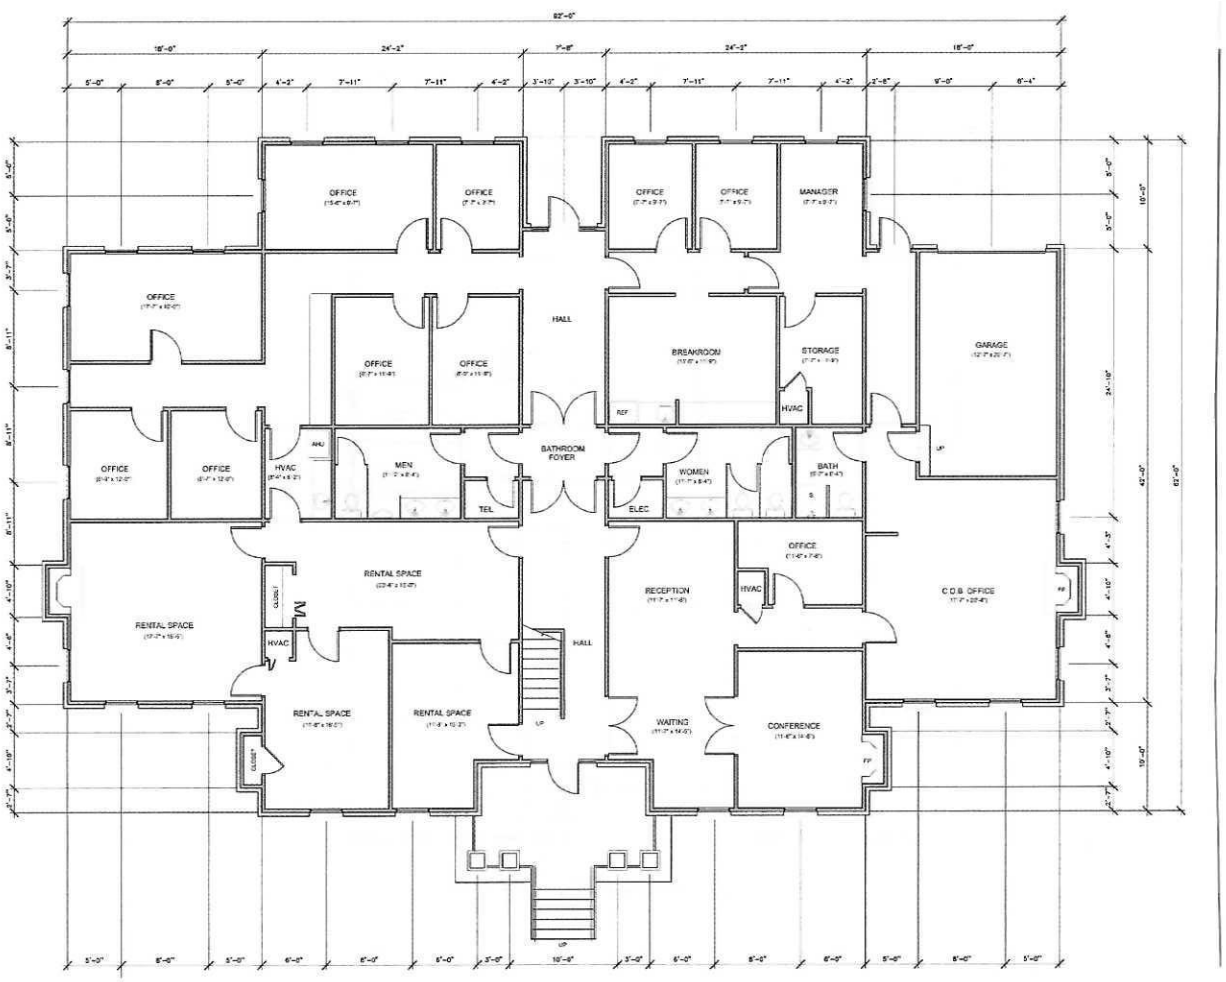

FIRST FLOOR PLAN (AS BUILT)
SCALE: 3/16" = 1'-0"

Copyright © 2025 Conn Architects. All rights reserved. This material may not be published, broadcast, rewritten or redistributed in whole or part without the express written permission of the image author.
The information shown or contained herein is believed accurate, but not warranted or guaranteed, is subject to errors, omissions and changes without notice and should be independently verified. License AACO01662.