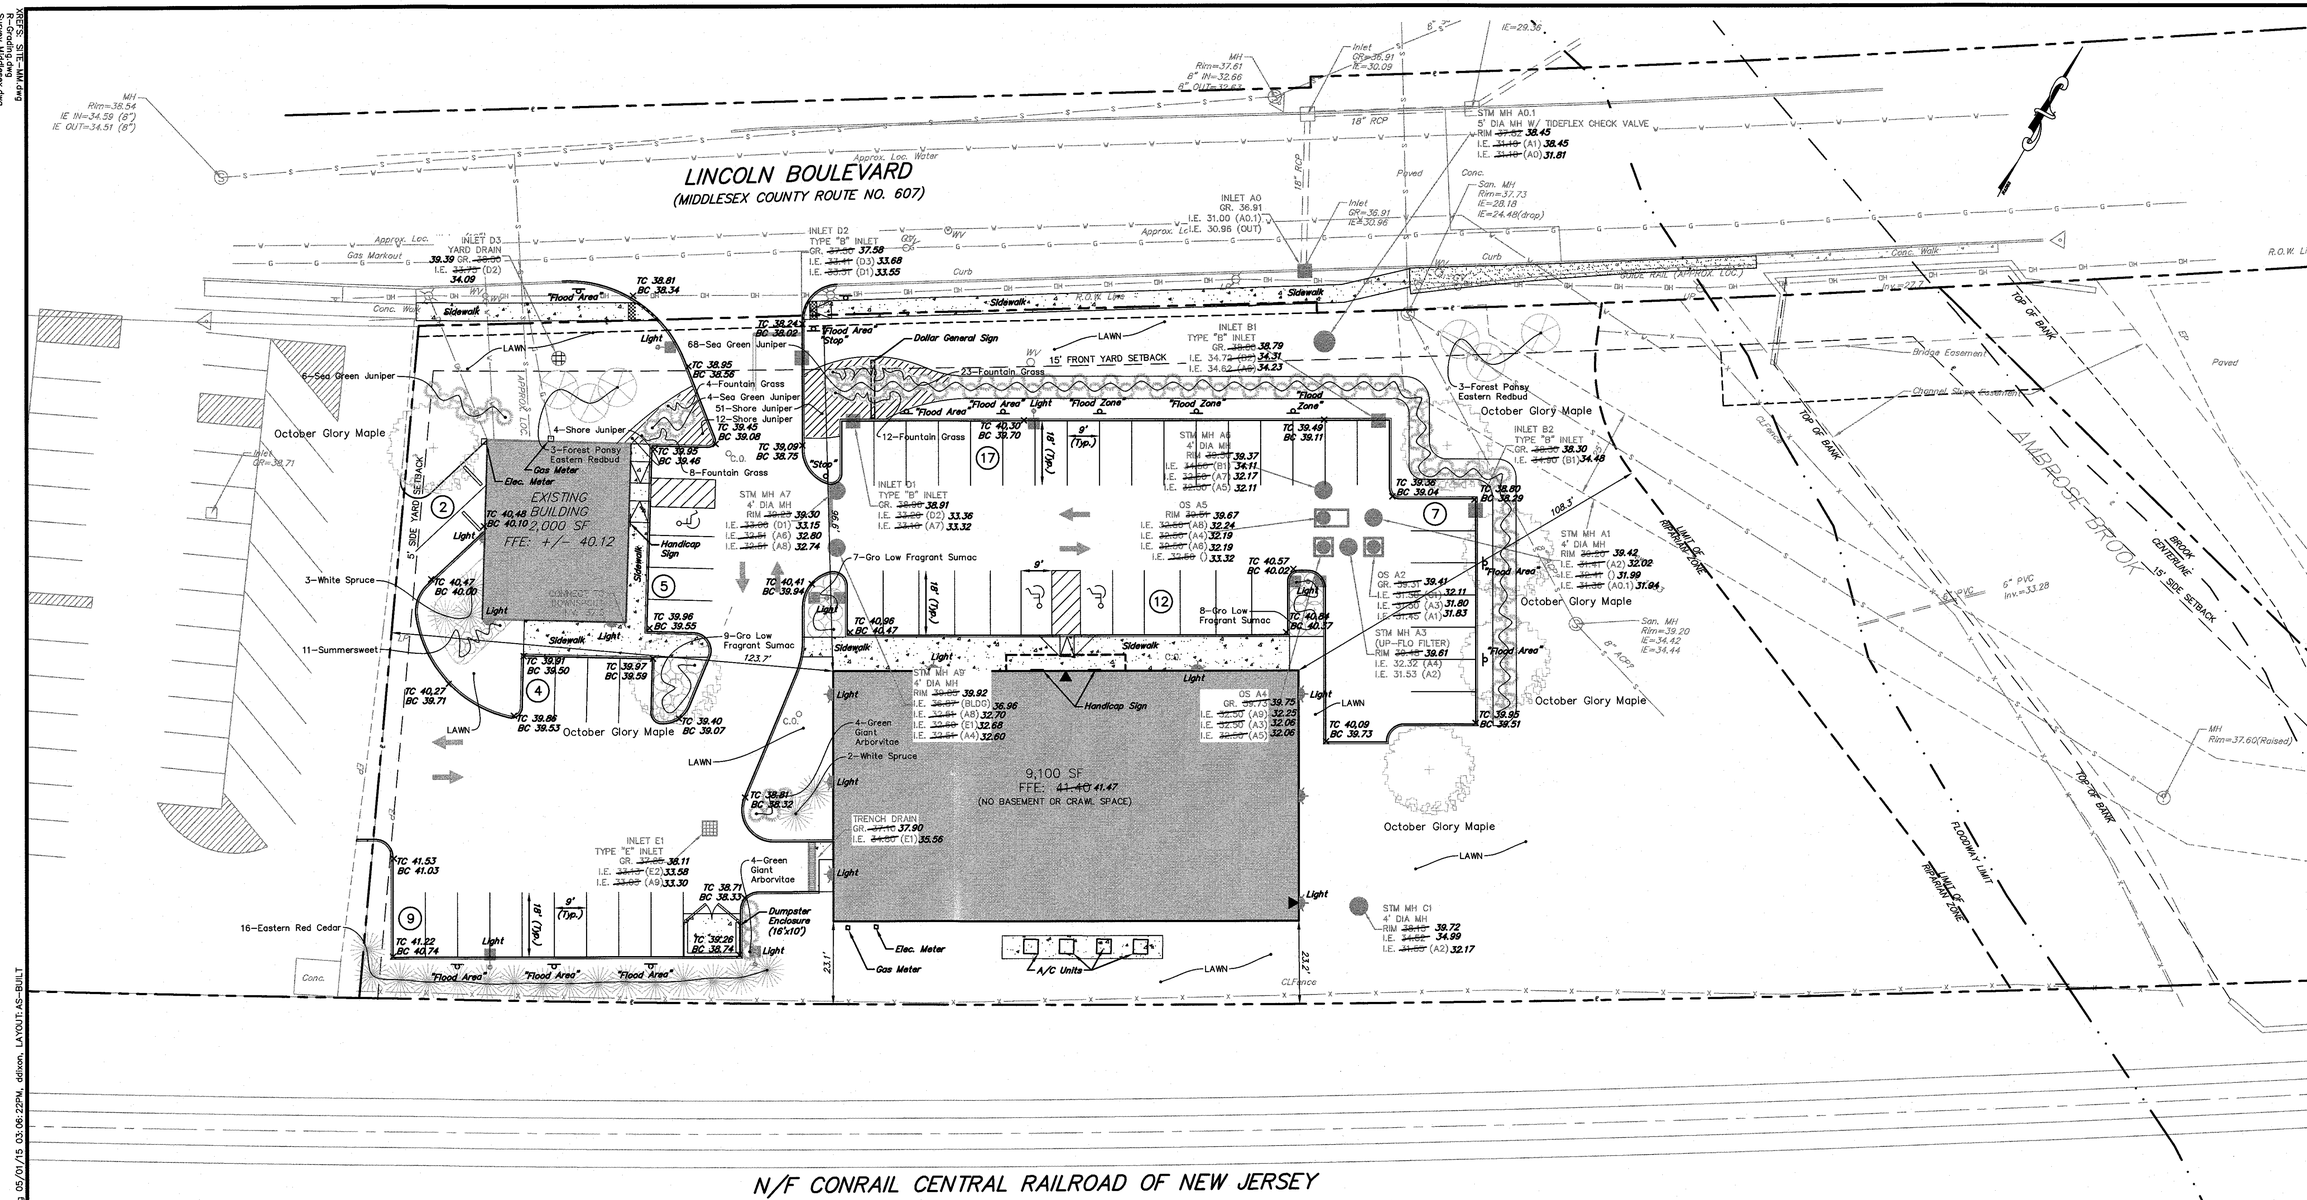

SCALE: 1"=20'

0 20 40 80 ft.

REVISIONS	
6	
5	
4	
3	
2	
1	

DATE: 04/27/2015
PROJ.: 130308
SCALE: 1" = 20'
CHKD. DP

54 Horsehill Road
Cedar Knolls, New Jersey 07927
Phone 973-359-8400
FAX 973-359-8455
E-mail: omland@omland.com
NJ Certificate of Authorization No. 24GA28043700

OMLAND
ENGINEERING ASSOCIATES, INC.

STANLEY T. OMLAND, N.J. Professional Engineer Lic. 24GE03698600
DAVID B. DIXON, N.J. Professional Land Surveyor Lic. 24GS02728200

COPYRIGHT © 2015 OMLAND ENGINEERING ASSOCIATES, INC. ALL INFORMATION CONTAINED HEREIN IS AUTHORIZED FOR USE BY THE PERSON OR ENTITY FOR WHOM THE WORK WAS CONTRACTED OR TO WHOM IT IS CERTIFIED. REUSE, REVISION, REPRODUCTION, COPIES, RELEASE, DISCLOSURE, DISTRIBUTION OR DISPOSITION TO ANY OTHER PERSON FOR ANY PURPOSE WITHOUT THE WRITTEN CONSENT OF OMLAND ENGINEERING ASSOCIATES, INC. COPYRIGHT 2015 OMLAND ENGINEERING ASSOCIATES, INC. ALL RIGHTS RESERVED.

PRELIMINARY AND FINAL MAJOR SITE PLANS FOR

TCAT PROPERTIES

AS BUILT PLAN

BLOCK 340, LOT 37.01 & 40

BOROUGH OF MIDDLESEX, MIDDLESEX COUNTY, NEW JERSEY

SHEET No. 1 OF 1

REFERENCES:
PLAN SET ENTITLED "PRELIMINARY AND FINAL SITE PLANS FOR TCAT PROPERTIES, BLOCK 340, LOT 37.01 & 40, BOROUGH OF MIDDLESEX COUNTY, NEW JERSEY, DATED JANUARY 24, 2014, REVISED THROUGH JANUARY 22, 2015, PREPARED BY OMLAND ENGINEERING ASSOCIATES, INC.

LEGEND

- GRANITE BLOCK CURB
- DEPRESSED OR FLUSH CURB
- DEPRESSED CONCRETE CURB
- POLE MOUNTED LIGHT
- SIGN
- WALL MOUNTED LIGHT
- DOOR LOCATION
- MANHOLE
- TRENCH DRAIN
- INLET TYPE "B"
- YARD DRAIN
- INLET TYPE "E"

H:\Projects\Codprof\130308 Maine-Middlesex\dwg\C30\06 - Revised Site Plans\SHT-AS-BUILT.dwg 05/01/15 03:06:22PM, ddixon, LAYOUT:AS-BUILT
XREFS: SITE-XMF.dwg
R-Grading.dwg
Survey Middlesex.dwg
SURVEY-AS-BUILT.dwg