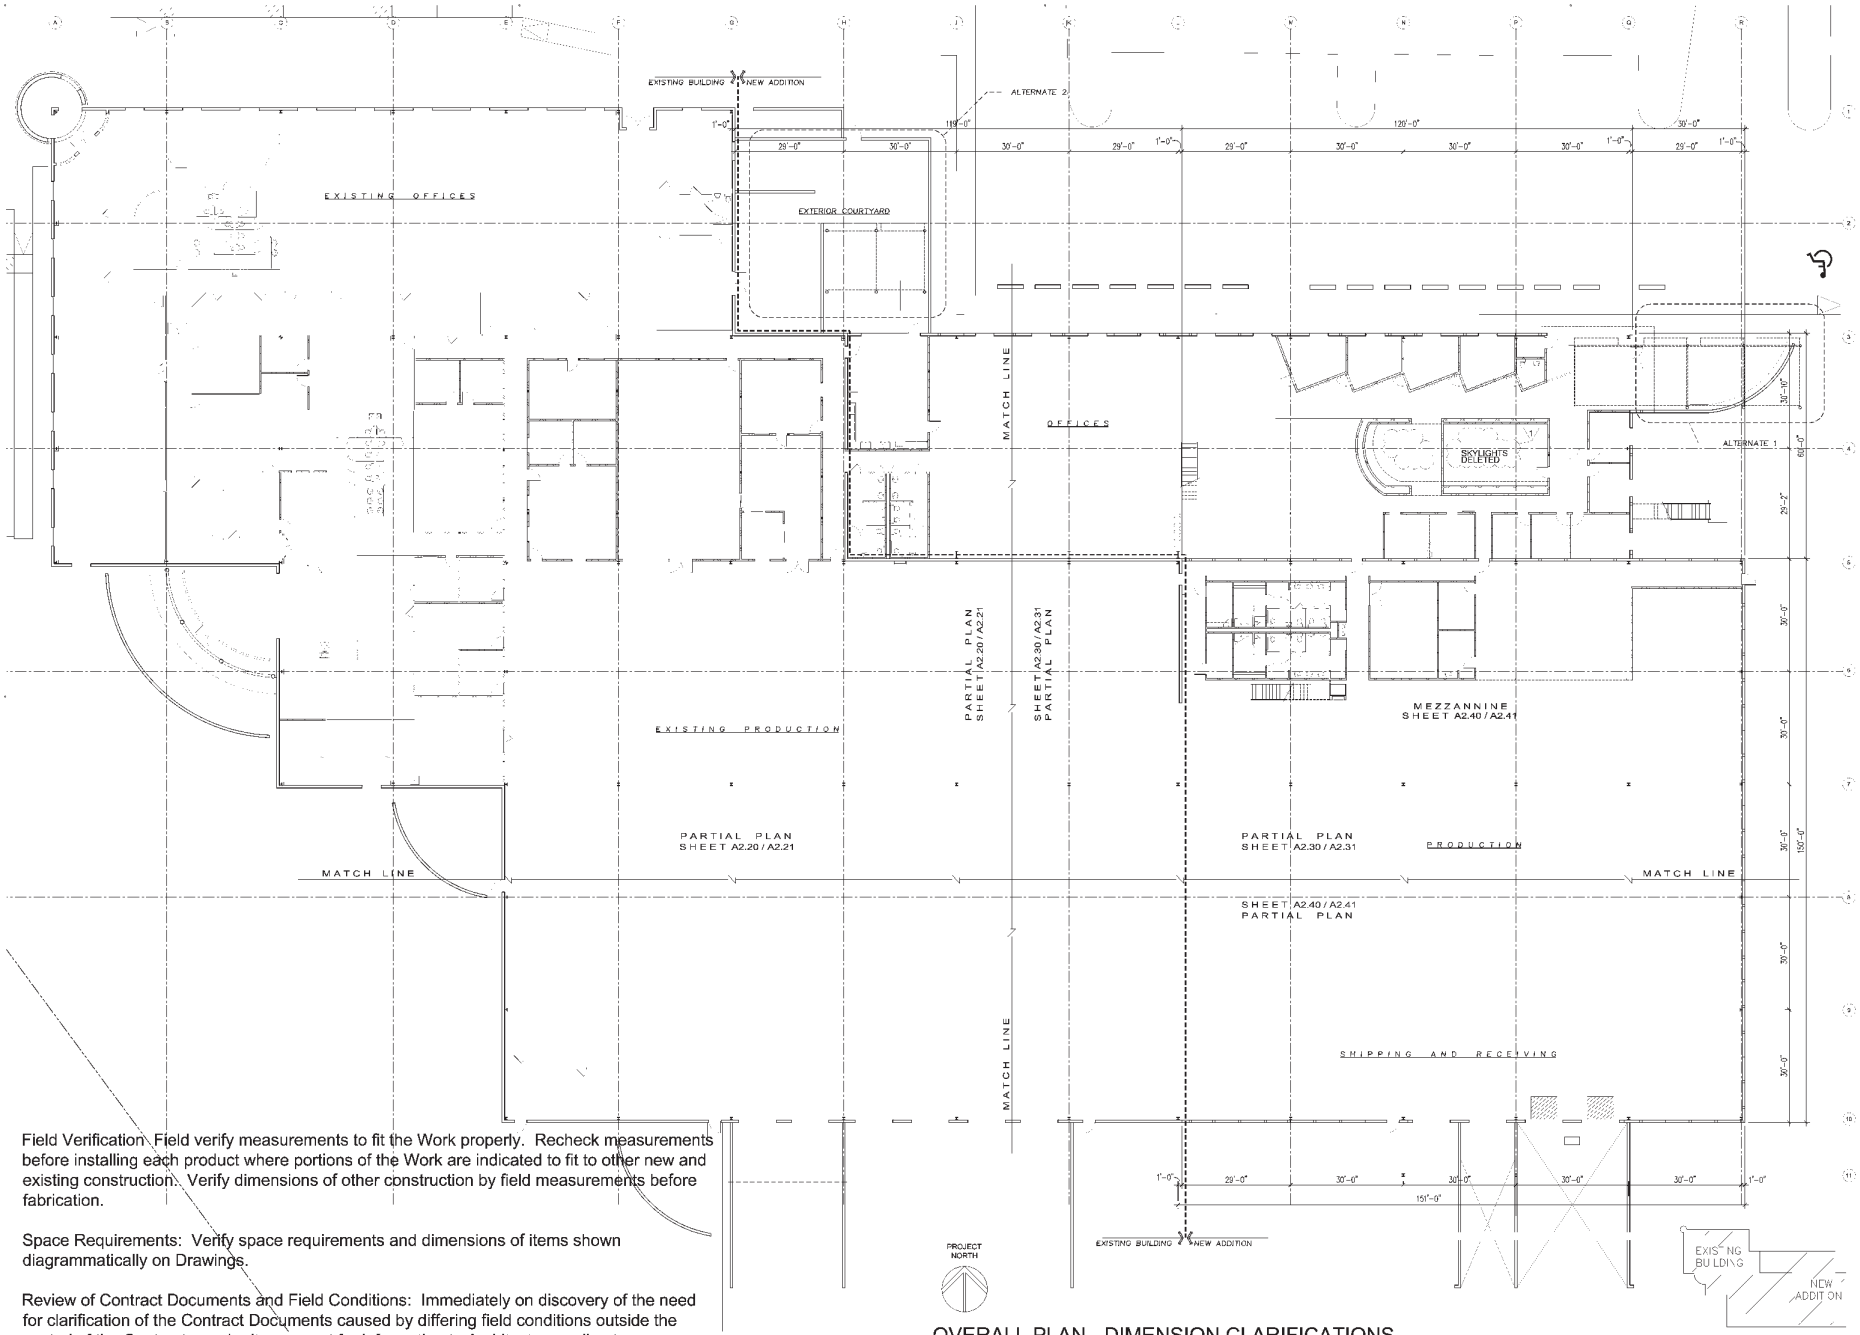

Field Verification: Field verify measurements to fit the Work properly. Recheck measurements before installing each product where portions of the Work are indicated to fit to other new and existing construction. Verify dimensions of other construction by field measurements before fabrication.

Space Requirements: Verify space requirements and dimensions of items shown diagrammatically on Drawings.

Review of Contract Documents and Field Conditions: Immediately on discovery of the need for clarification of the Contract Documents caused by differing field conditions outside the control of the Contractor, submit a request for information to Architect according to requirements in Division 01 Section "Project Management and Coordination."

OVERALL PLAN - DIMENSION CLARIFICATIONS

SCALE: 1/16" = 1'-0"

KEY PLAN

TERVIS TUMBLER EXPANSION

201 TRIPLE DIAMOND BOULEVARD
NORTH VENICE, FLORIDA

DATE:	ISSUE:
06.28.2010	CONSTRUCTION
07.27.2010	ADDENDA 1
08.05.2010	DELETE SKYLIGHTS-REV. 1
09.10.10	DIM. CLARIF.

GENERAL NOTES:

THESE DOCUMENTS ARE PRIMARILY CONCERNED WITH DESCRIBING THE PROJECTS DESIGN INTENT. THE ARCHITECT IS THE PARTY RESPONSIBLE FOR ESTABLISHING AND MAINTAINING THE DESIGN DIRECTION. FORWARD ANY QUESTIONS RELATED TO THESE MATTERS TO THE ARCHITECT WHENEVER THEY ARISE. THESE DOCUMENTS ARE NOT INTENDED TO DESCRIBE MEANS OR METHODS OF CONSTRUCTION. THOSE MATTERS REMAIN THE RESPONSIBILITY OF THE CONTRACTOR.

EXHAUSTIVE RECONNAISSANCE WAS NOT CONDUCTED AT THE PROJECT SITE PRIOR TO CONSTRUCTION. UNFORSEEN FIELD CONDITIONS MAY EXIST. THE CONTRACTOR IS RESPONSIBLE FOR NOTIFYING THE ARCHITECT OF ANY DISCREPANCIES BETWEEN THESE DOCUMENTS AND ACTUAL FIELD CONDITIONS BEFORE PROCEEDING WITH THE WORK.

DO NOT SCALE DIMENSIONS FROM THESE DRAWINGS. WHEN INFORMATION IS NOT CLEARLY PROVIDED, OBTAIN EXACT INFORMATION FROM THE ARCHITECT BEFORE PROCEEDING WITH THE WORK.

THE ARCHITECT IS NOT RESPONSIBLE FOR CONSTRUCTION THAT IS NOT CARRIED OUT IN ACCORDANCE WITH THESE CONSTRUCTION DOCUMENTS. THE ARCHITECT IS NOT RESPONSIBLE FOR DECISIONS AND INTERPRETATIONS MADE BY THE CONTRACTOR, OWNER OT OTHER PARTIES.

COPYRIGHT 2010 HALL ARCHITECTS, PA.
DRAWINGS AND CONCEPTS MY NOT BE USED OR REPRODUCED WITHOUT THE WRITTEN PREMISSION OF THE ARCHITECT.

DESIGN BUILDER:
WILLIS A SMITH CONSTRUCTION, INC.
CGC024192
5301 N. LAKEWOOD RANCH BLVD
SARASOTA, FLORIDA 34240
telephone 941.366.3116
fax 941.364.5609

IN ASSOCIATION WITH:

ARCHITECT:
HALL ARCHITECTS, PA
AA0003405
1365 6TH STREET
SARASOTA, FLORIDA 34236
telephone 941.917.0883
fax 941.917.0899

CIVIL ENGINEER:
AM ENGINEERING
EB 4334
8340 CONSUMER COURT
SARASOTA, FLORIDA 32840
telephone 941.377.9178
fax 941.378.3789

STRUCTURAL ENGINEER:
STIRLING & WILBUR ENGINEERING GROUP, INC.
EB 6462
7085 SOUTH TAMIAMI TRAIL
SARASOTA, FLORIDA 34231
telephone 941.929.1552
fax 941.929.1553

MEP ENGINEER:
ATP ENGINEERING SOUTH, PL
EB 8908
1253 TALLEVAST ROAD
SARASOTA, FLORIDA 34243
telephone 941.360.2181
fax 941.360.2971

SEAL

GREGORY HALL, AIA AR0012930
ARCHITECT OF RECORD

OVERALL BUILDING PLAN

SCALE: AS NOTED

SHEET NUMBER

A2.10 | FS1