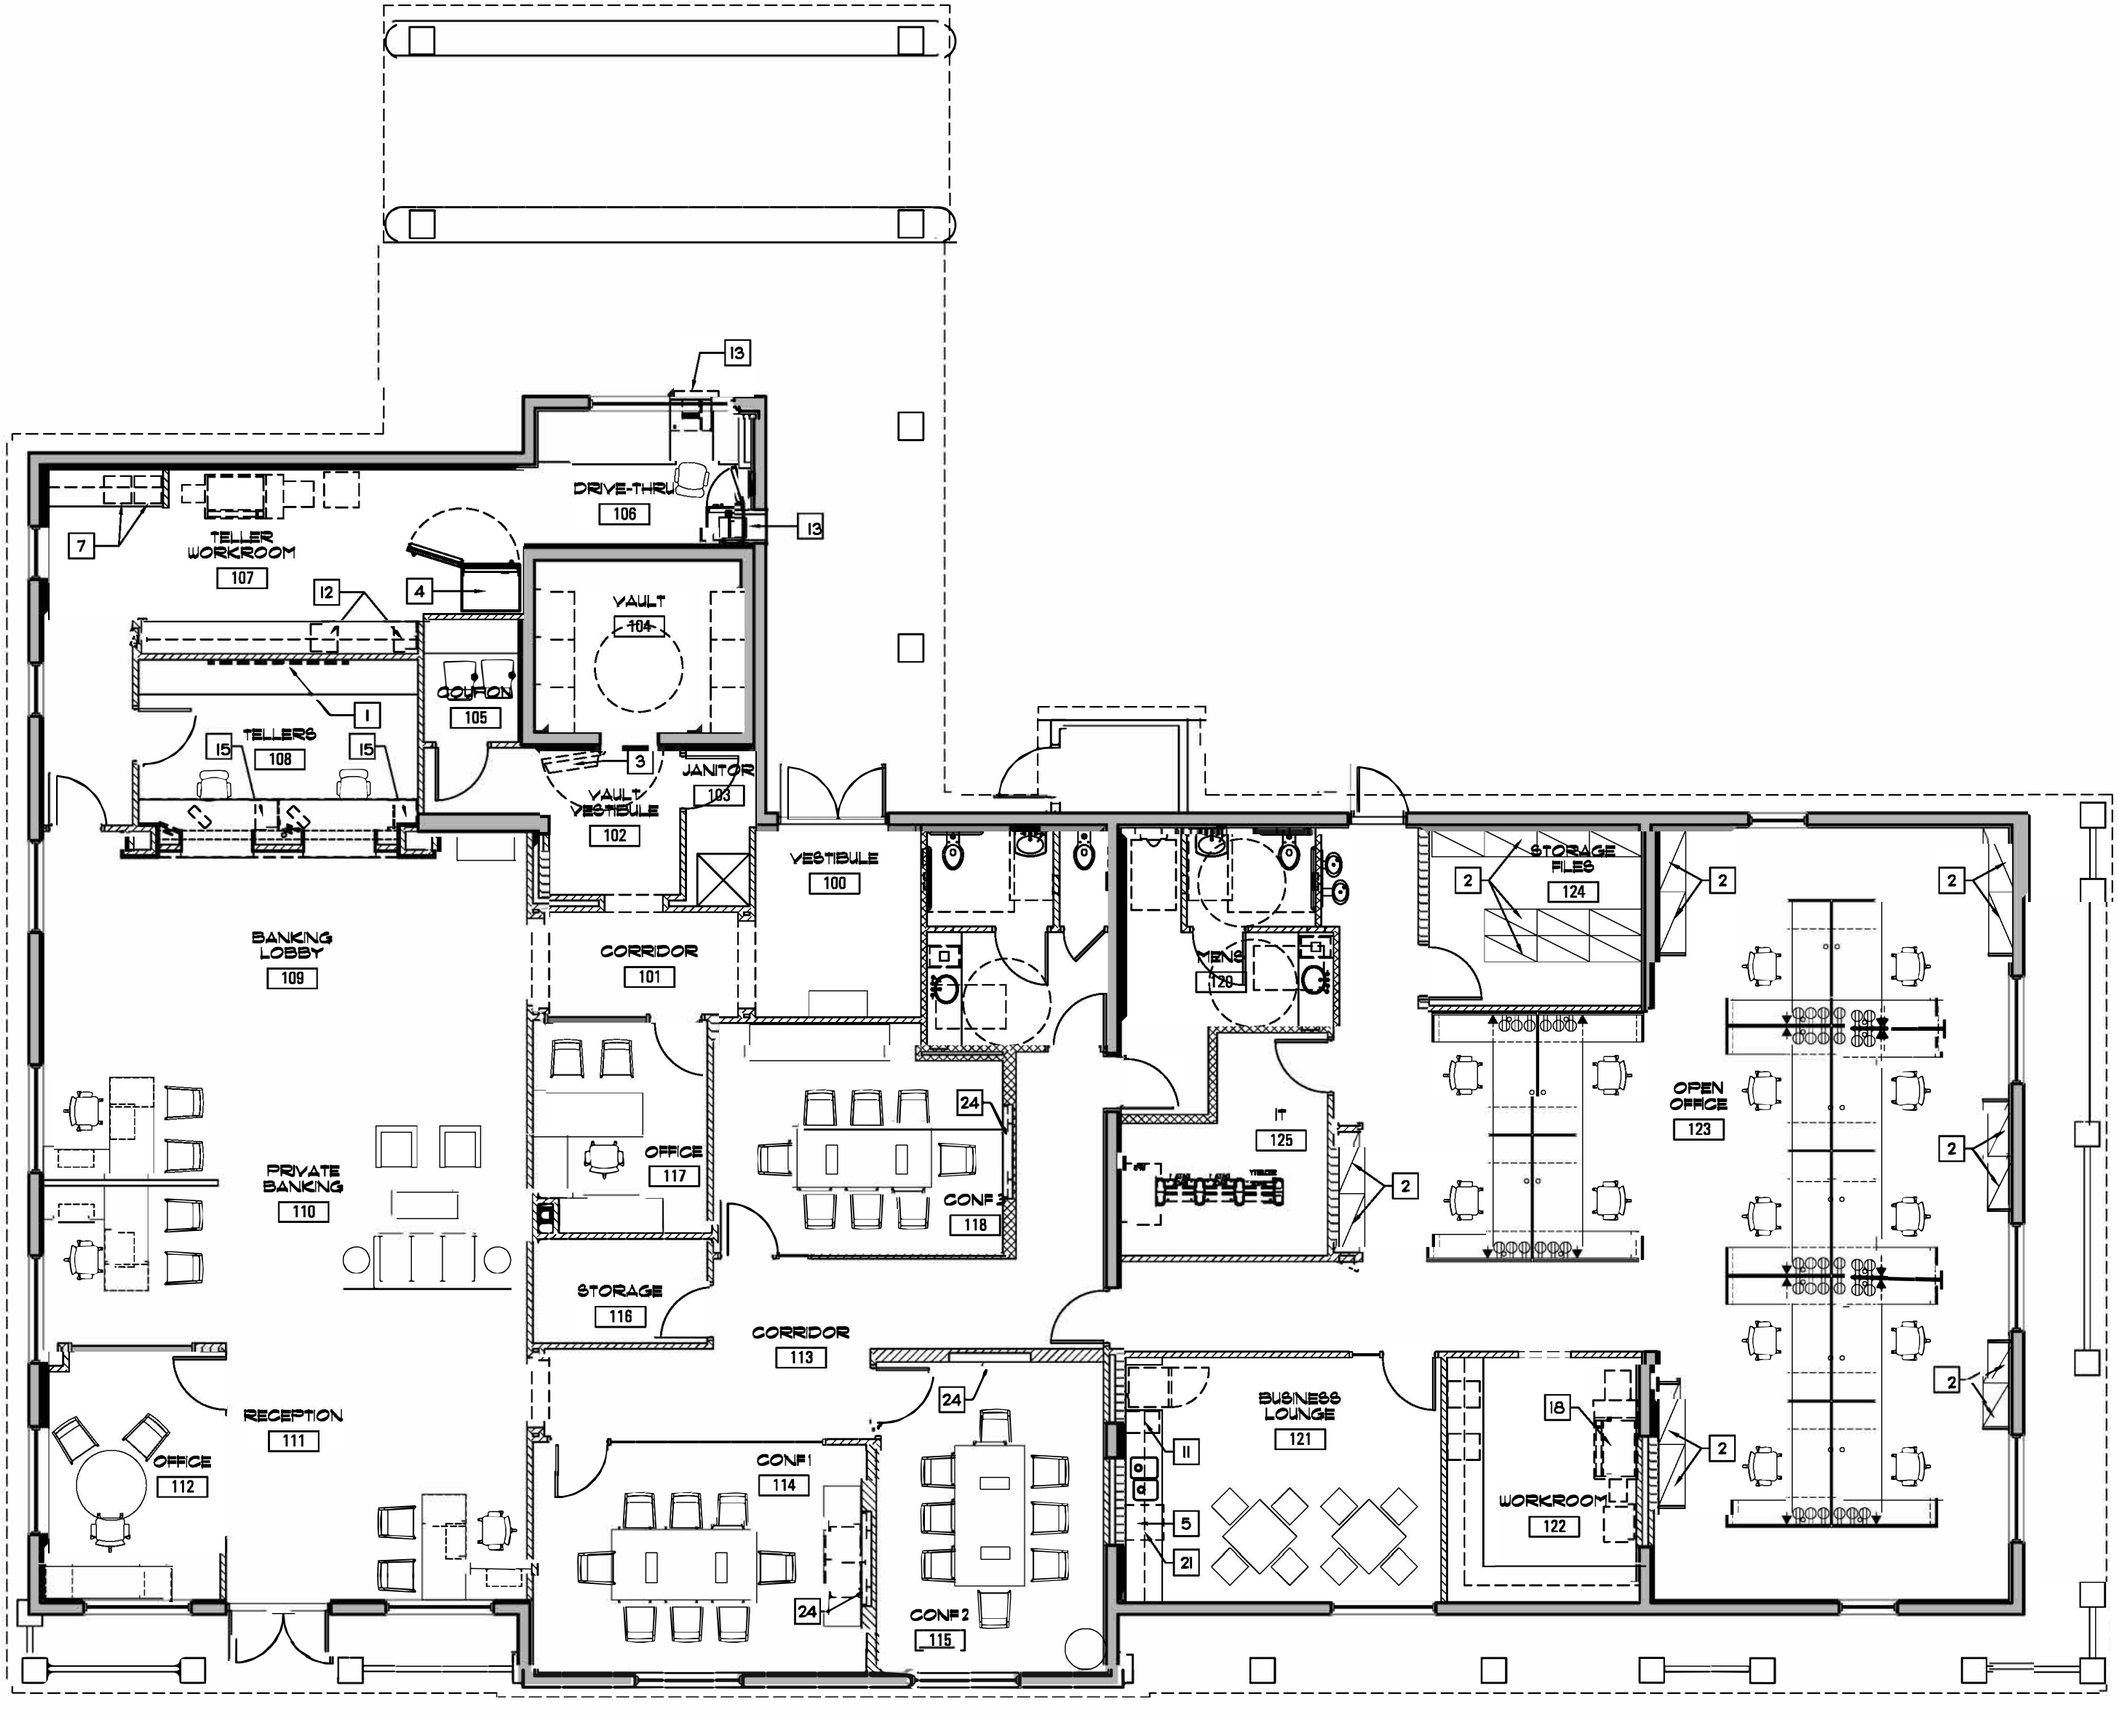
DRIVE-THRU
106
TELLER WORKROOM
107
VAULT
104
COUPON
105
TELLERS
108
VAULT VESTIBULE
102
JANITOR
103
VESTIBULE
100
BANKING LOBBY
109
CORRIDOR
101
MENS
120
STORAGE FILES
124
OPEN OFFICE
123
PRIVATE BANKING
110
OFFICE
117
CONF 3
118
IT
125
STORAGE
116
CORRIDOR
113
RECEPTION
111
OFFICE
112
CONF 1
114
CONF 2
115
BUSINESS LOUNGE
121
WORKROOM
122