LEGEND

- PARCEL BOUNDARY
- PARCEL BOUNDARY BUFFER
- EXISTING BUILDING
- PROPOSED CONCRETE PAVEMENT
- PROPOSED CONCRETE SIDEWALK
- PROPOSED ASPHALT OVERLAY
- 20.00 PROPOSED CONTOUR
- 20.00 PROPOSED SPOT ELEVATION
- PROPOSED SURFACE FLOW

AS-BUILT

INFORMATION PROVIDED BY:
DATE: JUNE 6, 2024
NAME: EILAND + ASSOCIATES, INC.
ADDRESS: 615 BLANDING BOULEVARD
ORANGE PARK, FLORIDA 32073
PHONE NO: 904-272-1000

I HEREBY CERTIFY THAT THE

X	PAVEMENT	____	WATERMAIN
X	CURB AND GUTTER	____	SANITARY SYSTEM
____	STORMWATER DRAINAGE SYSTEM	____	FORCE MAIN
____		____	LIFT STATION
____	UNDERDRAIN CONNECTIONS	____	POND

ARE AT THE HORIZONTAL AND VERTICAL LOCATIONS AS SHOWN ON THESE "AS-BUILT" DRAWINGS AND MEET THE MINIMAL TECHNICAL STANDARDS SET FORTH BY THE FLORIDA BOARD OF LAND SURVEYORS PURSUANT TO SECTION 472.027, FLORIDA STATUTES.

SIGNATURE: [signature]

DATE: JUNE 6, 2024

FLORIDA REG. LAND SURVEYOR'S NO: LS 2518

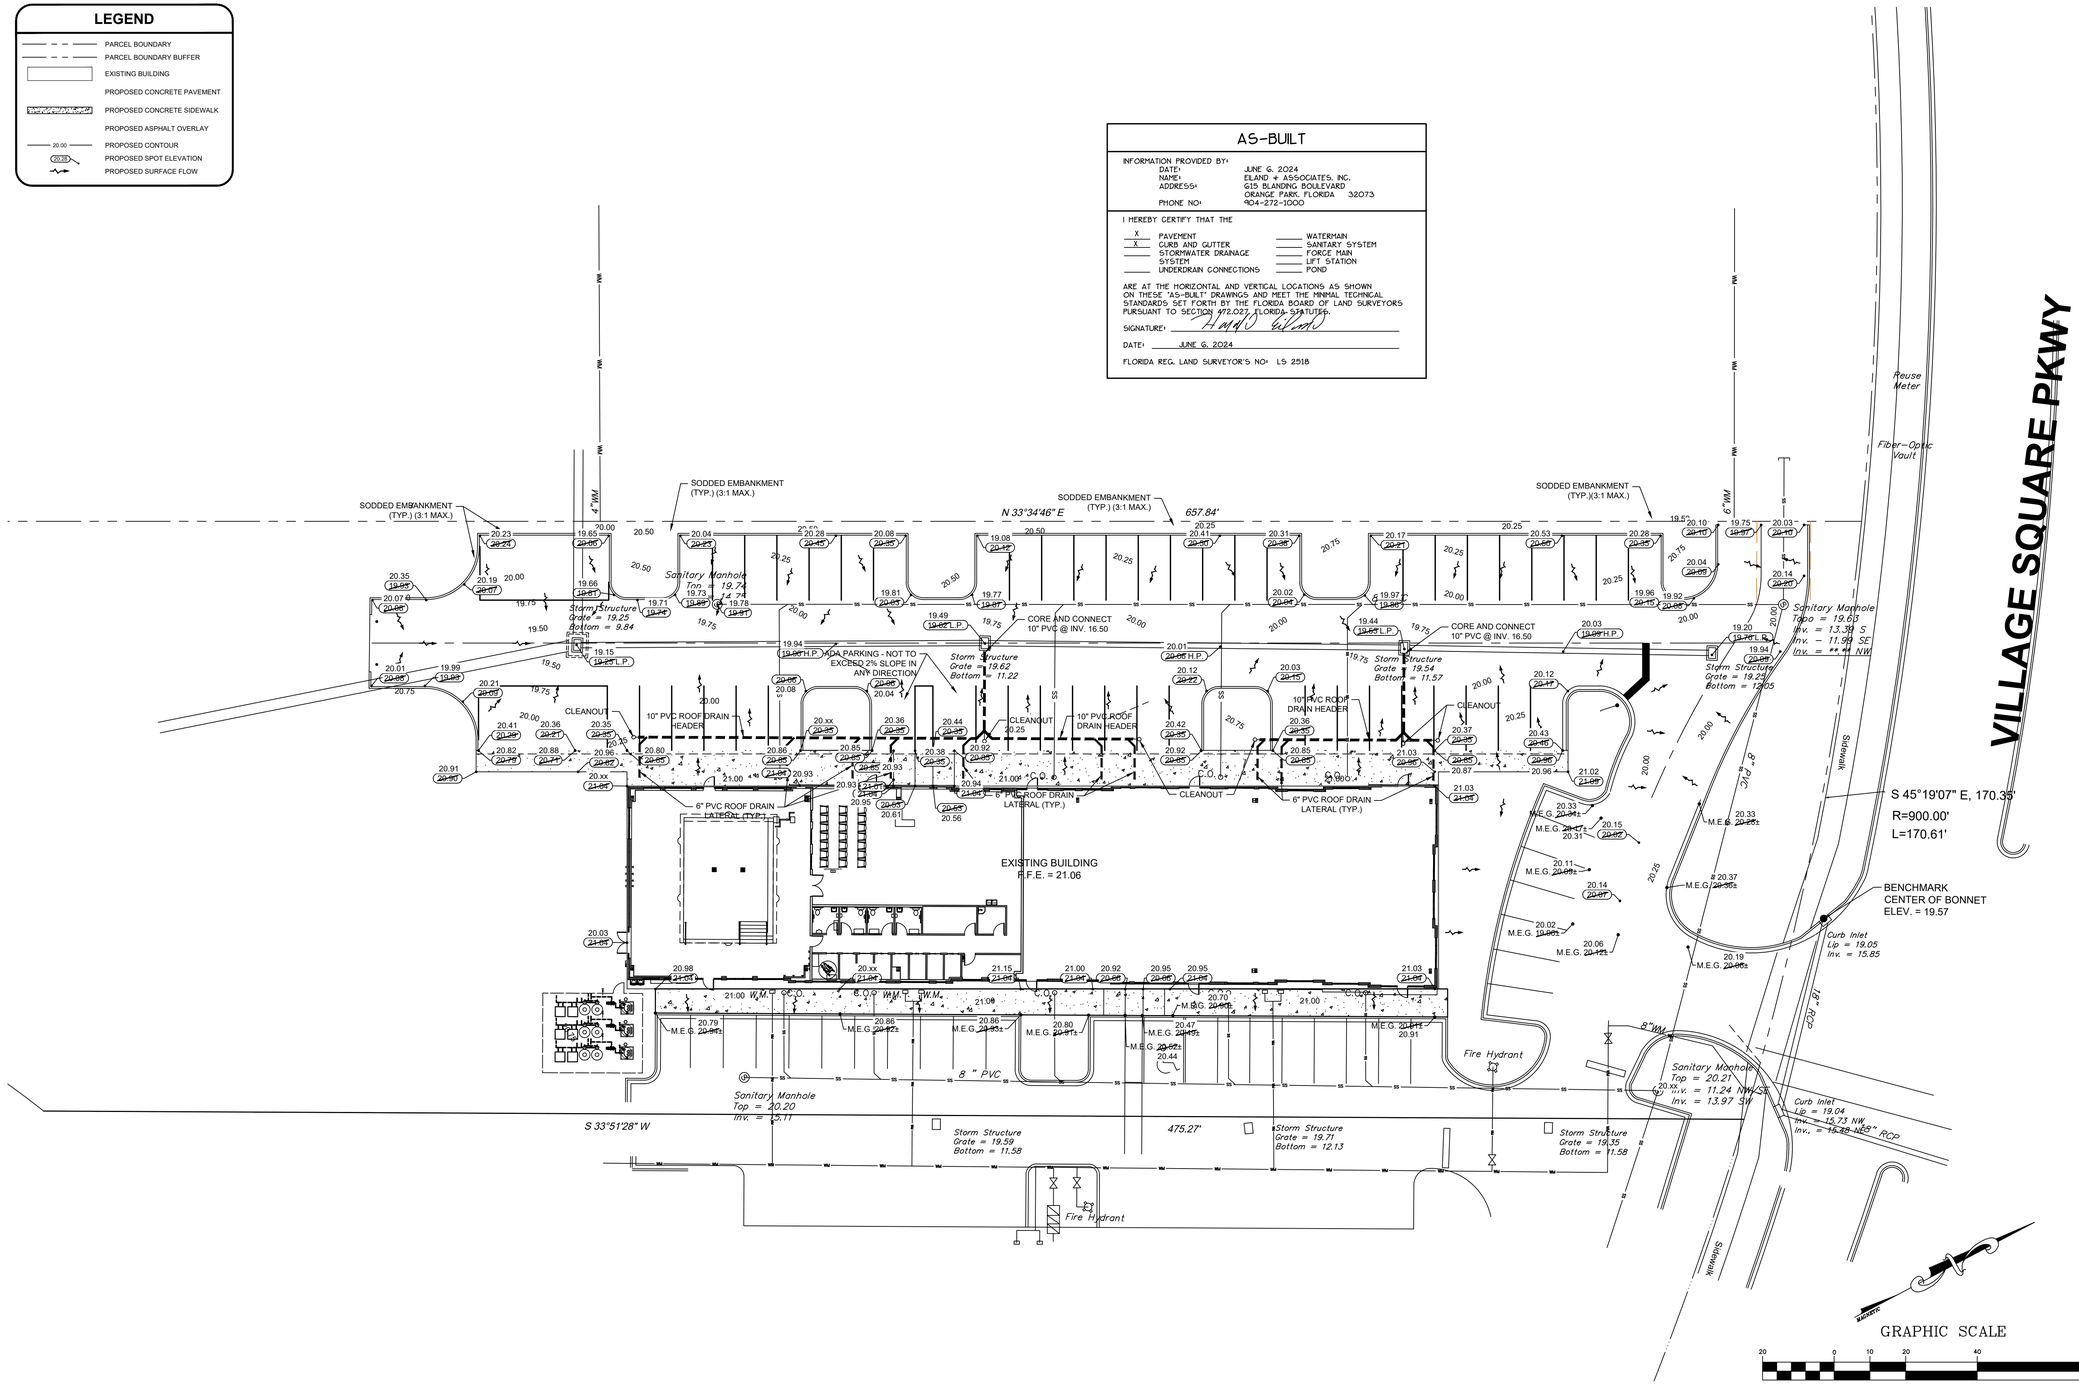

AS-BUILT

300

REVISIONS			
NO.	DATE	DESCRIPTION	BY:

DESIGNED BY: PROSSER
DRAWN BY: DEL
CHECKED BY: HTI
SCALE: N.T.S.
DATE: JULY 2021
PROJ. NO.: 42641

Eiland & Associates, Inc.
PROFESSIONAL SURVEYORS & MAPPERS
615 BLANDING BOULEVARD
ORANGE PARK, FLORIDA 32073
TELEPHONE: (904) 272-1000

AQUA FIN
GRADING AND DRAINAGE PLAN

ASBUILTS

FILE:

C:\Civil 3D Projects\44038 AquaFin Swim Topo\Grading and Drainage Plan.dwg 6/6/2024 9:52:44 AM, DWG To PDF.pc3